

ADDENDUM TO THE BID DOCUMENTS		Page: 1	Total Pages: 3
<u>Addendum No:</u> # 1		<u>Date this Addendum Issued:</u> May 19, 2017	
<u>Issuing Office:</u> Matanuska-Susitna Borough School District (MSBSD) Purchasing Department 690 Cope Industrial Way Palmer, Alaska 99645 Phone: (907) 861-5120 Facsimile: (907) 861-5184		<u>Previous Addenda Issued:</u> None _____ _____ _____ _____	
<u>Return Acknowledgment To:</u> Issuing Department		<u>Date and Hour of Bid Due Date:</u> May 26, 2017 at 2:00 p.m.	
<u>Bid Title:</u> Big Lake Elementary School Water System Modifications		<u>As Advertised (Frontiersman):</u> May 7 and 10, 2017	
<u>Bid No:</u> B17-25		<u>As Advertised (ADN):</u> May 5 and 7, 2017	
<p>The following corrections, changes, additions, deletions, revisions, and/or clarifications are hereby made a part of the contract documents. In case of conflicts between this addendum and previously issued documents, this addendum shall take precedence. The bidder must acknowledge receipt of this addendum in the space provided on Appendix #1. Failure to do so may subject the bidder to disqualification.</p> <p>This addendum incorporates the attached 2 pages.</p> <p>Attachments:</p> <p>Clarifications (1 page) Appendix 8, Edited Drawing, Sheet C2 (1 page)</p>			
END OF ADDENDUM #1			

APPROVED BY:	Signature on File	DATE:	May 19, 2017
--------------	-------------------	-------	--------------

**MATANUSKA-SUSITNA BOROUGH SCHOOL DISTRICT
PURCHASING DEPARTMENT
690 COPE INDUSTRIAL WAY
PALMER, AK 99645**

**BIG LAKE ELEMENTARY SCHOOL
WATER SYSTEM MODIFICATIONS
BID #B17-25**

ADDENDUM #1

Information in this addendum takes precedence over original information. All other provisions of the document remain unchanged.

Note to Bidders: Bidders are required to acknowledge all addenda on Appendix 1.

The following additions, corrections and changes are hereby made to the above-referenced Invitation to Bid.



QUESTIONS AND ANSWERS:

1. Q: Please clarify the surface composition of the area on the left of the School building. It is not shown as paved on the drawings.

A: The entire Bus Loop section is now paved. Paving extends across the entire driveway. See Appendix 8, Edited Drawing, Sheet C2 attached.

NOTES:

1. EXISTING WELL PIT STRUCTURE AND INTERIOR COMPONENTS TO BE ABANDONED IN PLACE OR REMOVED AS REQUIRED FOR CONSTRUCTION OF NEW WATER SERVICE IMPROVEMENTS. REMOVAL OF INTERIOR COMMENTS SHALL INCLUDE:
 - 1.1. ELECTRICAL PANEL, LIGHTS, HEATERS, SWITCHES AND ALL WIRING.
 - 1.2. SUMP PUMPS AND ASSOCIATED PIPING
 - 1.3. WATER PIPE AND PLUMBING COMPONENTS UP TO BUT NOT INCLUDING PITLESS ADAPTER.
2. FINISH GRADE SHALL MATCH EXISTING GRADE ELEVATIONS UNLESS SHOWN OTHERWISE.
3. EXISTING WATER PIPE ABANDONED IN PLACE OR REMOVED AS REQUIRED FOR CONSTRUCTION OF NEW AIP

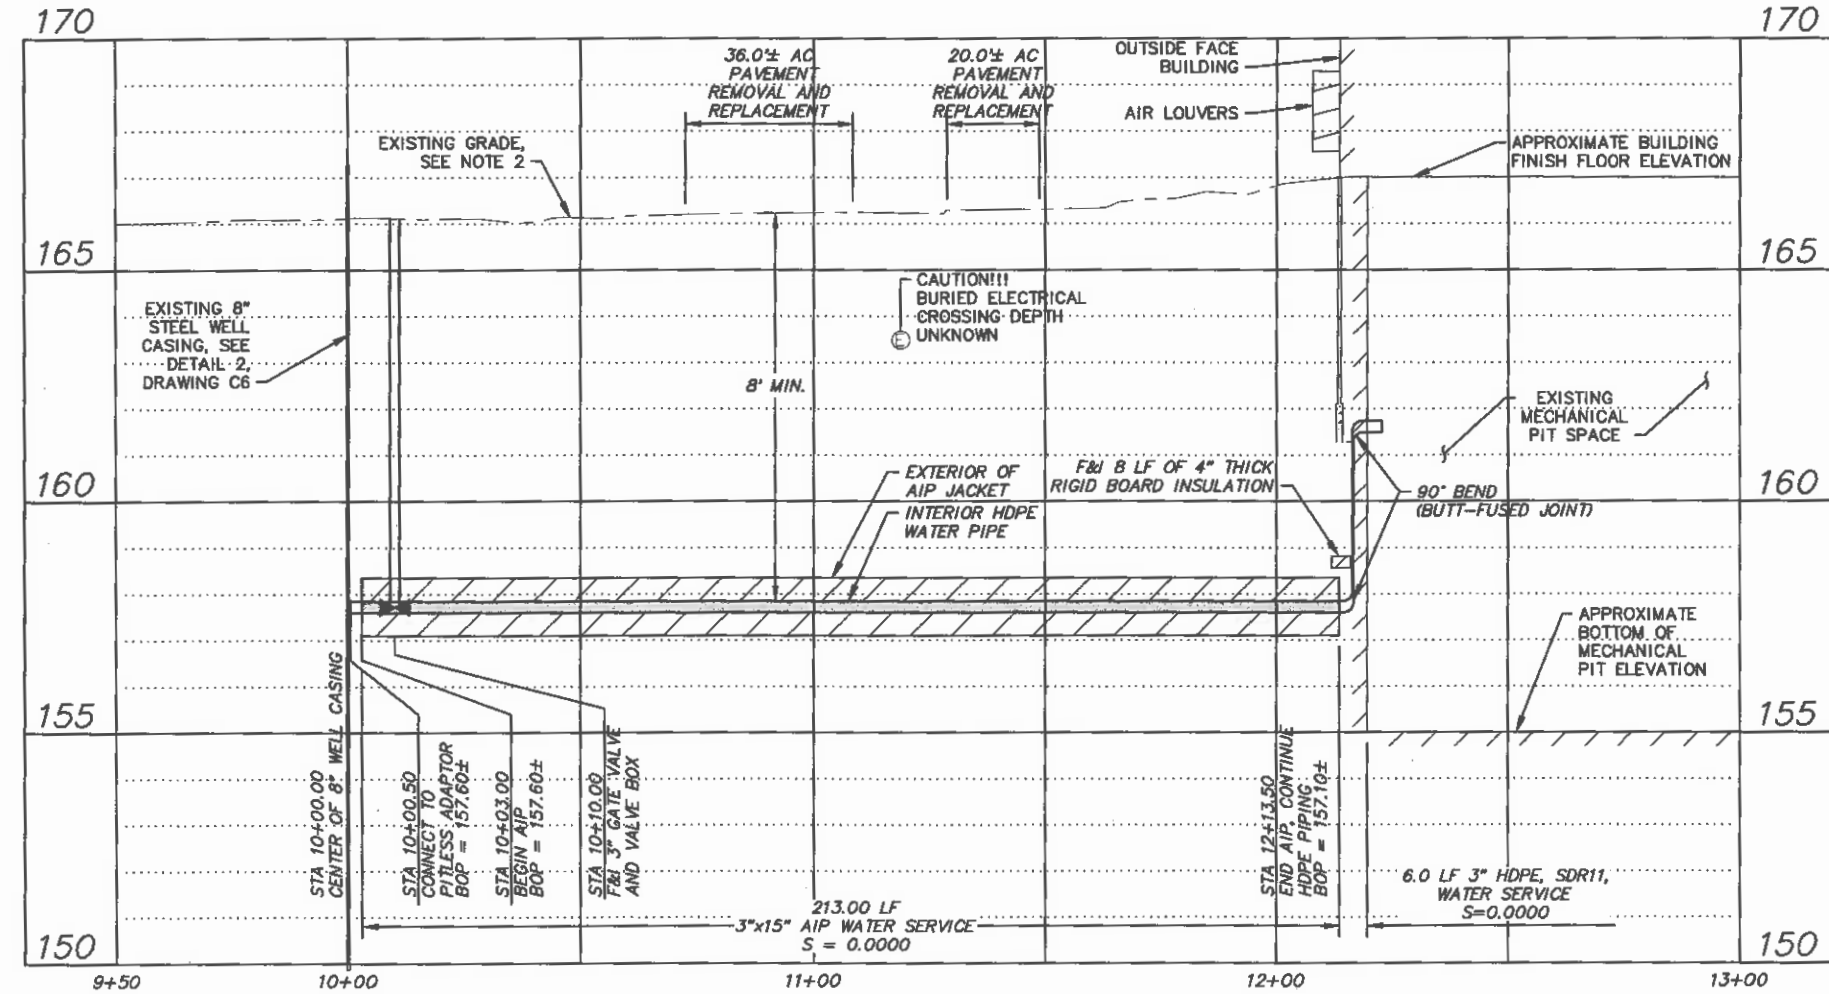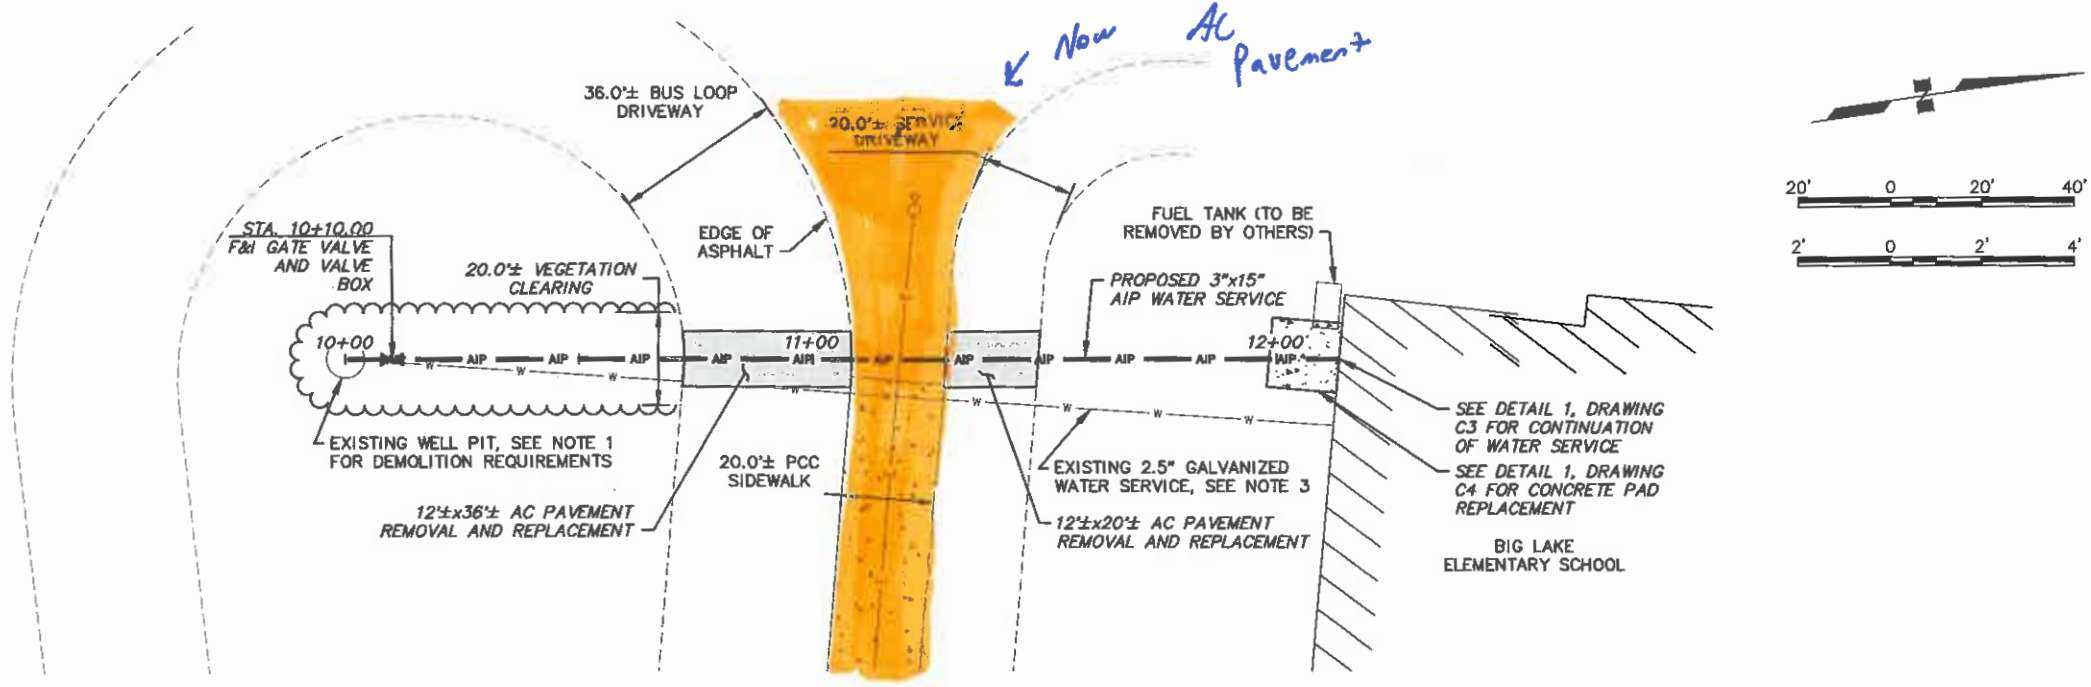

ACAD FILE: J:\PROJECTS\31001\01_MSSD_BIG LAKE_ELEM_WATER_SYSTEM\00_DADD\01_WORKING SET\01_CIVIL\31001_01_WATER_SERVICE_PLAN_AND_PROFILE.DWG Plot Date: 2/17/2017 1:15 PM

MATANUSKA SUSITNA BOROUGH SCHOOL DISTRICT

CRW ENGINEERING GROUP, LLC
 3940 ARCTIC BLVD. SUITE 200
 ANCHORAGE, ALASKA 99503
 PHONE: (907) 562-3352
 FAX: (907) 562-3352

MATANUSKA-SUSITNA BOROUGH SCHOOL DISTRICT
 FACILITIES DEPARTMENT
 BIG LAKE ELEMENTARY SCHOOL
 WATER SYSTEM MODIFICATIONS
 WATER SERVICE PLAN AND PROFILE

REV	DATE	DESCRIPTION

DATE: FEB 2017
 STATUS: DRAFT
 SCALE:
 HORIZ SCALE: 1"=20'
 VERT SCALE: 1"=2'
 SHEET NO.
C2